
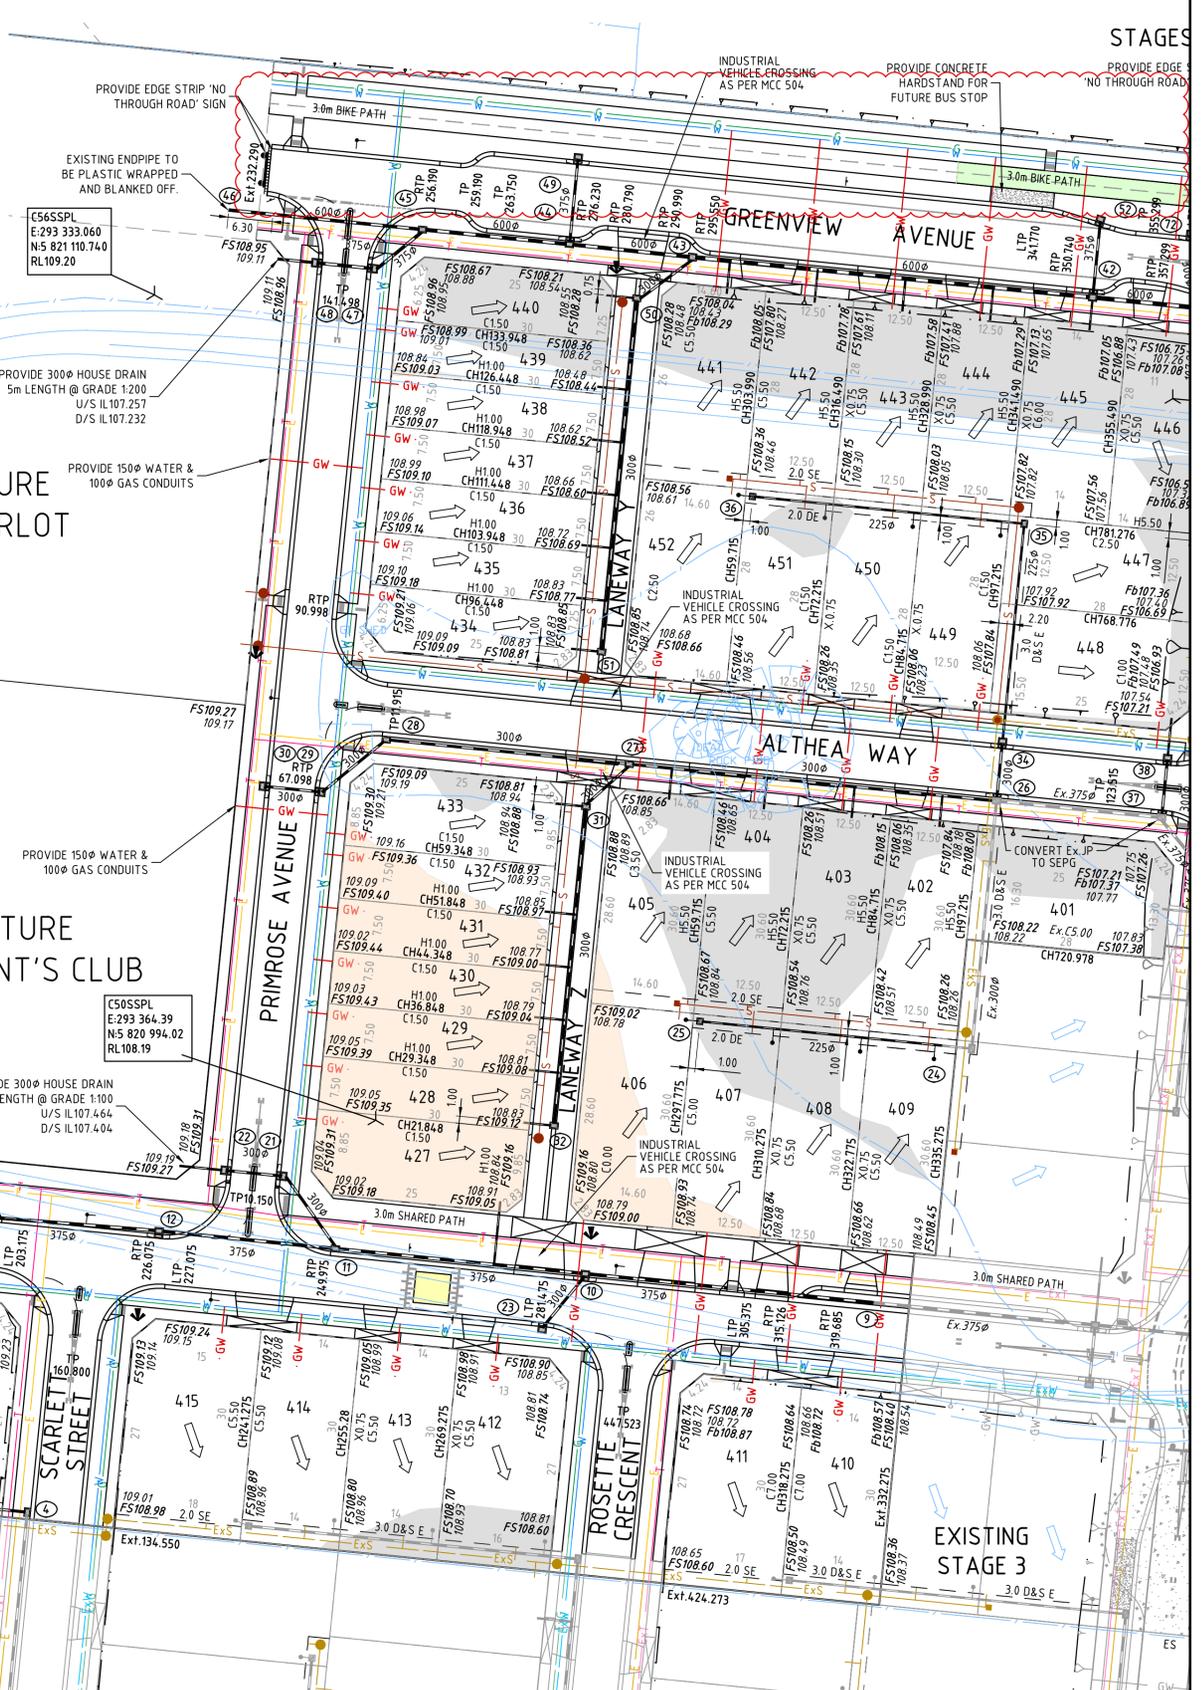
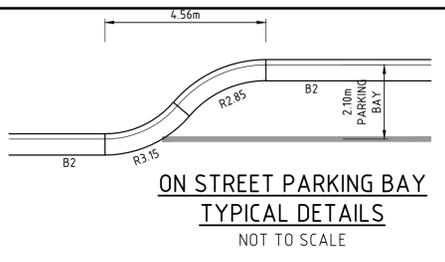
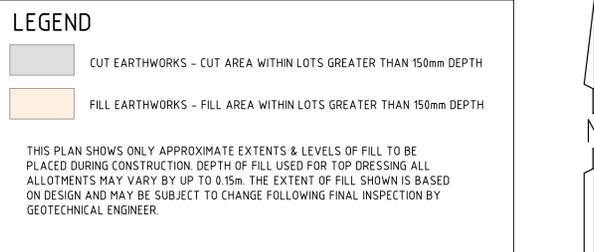


LEGEND

- B2 600 B2 TYPE KERB AS PER EDMC 301
- ES 150x150mm CONC. EDGE STRIP WITH SUBSOIL DRAINS UNDER.
- TEMPORARY TURNING AREA INCLUDING BOLLARDS AND "NO ROAD" SIGN.
- PROPOSED RAISED PAVEMENT.
- PROPOSED GAS & WATER/RECYCLED WATER CONDUITS
- PROPOSED ELECT. & TELECOMM. CONDUITS
- EXISTING SURFACE CONTOURS (0.25m INT.)
- DIRECTION OF LOT FINISHED SURFACE FALL / OVERLAND FLOW PATH
- 3.0m BIKE PATH
- 3.0m BIKE PATH. REFER TO EDMC 401 FOR DETAILS.
- ULTIMATE WATERWAY CHANNEL. (SHAPING ARE SHOWN AS INDICATIVE ONLY)
- PROPOSED BOLLARDS AS PER LANDSCAPE PLAN

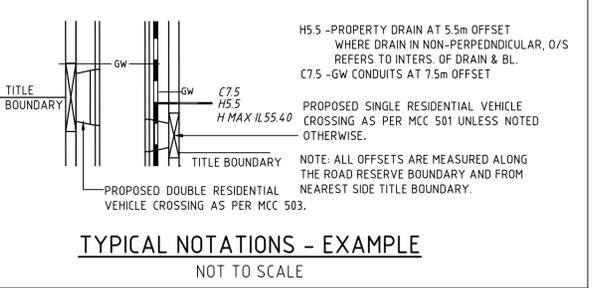

C58SSPL
E:293 103.44
N:5 821 037.97
RL:109.97

C3SSPT
E:293 112.07
N:5 820 959.31
RL:109.97

C32RVTL
E:293 108.60
N:5 820 954.65
RL:110.50

FUTURE TOWN PARK RESERVE

FUTURE RESIDENT'S CLUB

DISCLAIMER

THE CONTENT ON THIS PLAN IS FOR PRELIMINARY PURPOSES ONLY AND IS SUBJECT TO THE FORMAL PLANNING APPROVAL BY CITY OF MELTON, DETAILED ENGINEERING DESIGN AND APPROVALS FROM CITY OF MELTON AND ALL SERVICE AUTHORITIES. AS SUCH THIS PLAN IS SUBJECT TO CHANGE WITHOUT NOTICE. THIS PLAN IS NOT TO BE USED FOR ANY PURPOSE OTHER THAN FOR PRELIMINARY PURPOSES. HOUSE SITING SHOULD ONLY BE COMPLETED ONCE COUNCIL APPROVED PLANS ARE ISSUED. THE DEVELOPER BEARS NO RESPONSIBILITY FOR ANY OF THESE CHANGES. THE PURCHASER SHOULD ASCERTAIN THE DETAILS ARE CORRECT BEFORE PROCEEDING.

- NOTES**
- DESIGN LINE IS NOT IN CENTRE OF ROAD RESERVE. REFER TO CROSS SECTION FOR DETAILS.
 - REFER TO SHEET 1 FOR TBM DATA.
 - THIS PLAN SHOWS ONLY APPROXIMATE EXTENTS & LEVELS OF FILL TO BE PLACED DURING CONSTRUCTION. DEPTH OF FILL USED FOR TOP DRESSING ALL ALLOTMENTS MAY VARY BY UP TO 0.15m. THE EXTENT OF FILL SHOWN IS BASED ON DESIGN AND MAY BE SUBJECT TO CHANGE FOLLOWING FINAL INSPECTION BY GEOTECHNICAL ENGINEER.
 - DRAINAGE CO-ORDINATES SHOWN REFER TO CENTRE OF PIT/PIPE.

WARNING

BWARE OF UNDERGROUND SERVICES

THE LOCATIONS OF UNDERGROUND SERVICES ARE APPROXIMATE ONLY AND THEIR EXACT POSITION SHOULD BE PROVEN ON SITE. NO GUARANTEE IS GIVEN THAT ALL EXISTING SERVICES ARE SHOWN.

THIS DRAWING IS NOT TO BE COPIED OR SCALED

VERSION	REMARKS	DATE	BY
L	AS CON UPDATED	12.08.21	LP
K	AS CONSTRUCTED	25.06.19	DJK
J	PAINTED BIKE PATH AT INTERSECTION	26.03.19	LP
I	SUPERLOT & RESIDENT CLUB HOUSE DRAIN & CONDUITS	09.10.18	LP
H	FUTURE RESERVE CONDUIT REMOVED	16.04.18	LP

- LEGEND**
- FINISHED SURFACE AFTER CUTTING OR FILLING
 - TOP OF PROPOSED BATTER
 - PROPOSED PAVEMENT OR FOOTPATH SURFACE
 - EXISTING OR PROPOSED INVERT LEVEL OF PIPE OR OPEN DRAIN
 - TANGENT POINT
 - CHAINAGE
 - PSM
 - EX FENCE
 - EX WALL OR BUILDING
 - RECYCLED WATER
 - EX RECYCLED WATER
 - ELECTRICAL U.G. SERVICES
 - EX ELECTRICAL U.G. SERVICES
 - ELECTRICAL SERVICE & PIT
 - EX ELECTRICAL ASSETS
 - EX ELECTRICAL OVERHEADS
 - GAS & WATER CONDUITS
 - TOP OF BATTER
 - TOE OF BATTER
 - EX DRAIN & PIT
 - EX HOUSE DRAIN
 - EX SEWER AND MAINTENANCE HOLE
 - EX SEWER AND MAINTENANCE HOLE
 - WATER MAIN
 - EX WATER MAIN, VALVE & HYDRANT
 - GAS MAIN
 - EX GAS MAIN, VALVE
 - TELSTRA SERVICES & PITS
 - EX TELSTRA SERVICES & PITS

DRAWN BY	D.KONSTANDIS	DESIGNED BY	L.PHAN
MELWAY	344.H110	CHECKED BY	
DATUM	AHD	AUTHORISED BY	S.RAVIDA

REEDS CONSULTING

LAND SURVEYING
CIVIL ENGINEERING
PLANNING
DEVELOPMENT CONSULTING

www.reedsconsulting.com.au
engineering@reedsconsulting.com.au

Lvl 4, 440 Elizabeth Street Melbourne Victoria 3000
p (03) 8640 3000

CITY OF MELTON

BRIDGEFIELD ESTATE, ROCKBANK
STAGE 4
LAYOUT PLAN - 1

DRAWING No.	VERSION
4R2	L
REFERENCE	22236E/4
SHEET	2 OF 39

AS CONSTRUCTED

SERVICE SCHEDULE

ROAD NAME	GAS O/S	Dr.WATER O/S	ELECT. O/S	TELECOMM. O/S	SEWER O/S	BOK-T.B. DIST. U.N.O.	CARRIAGEWAY WIDTH (FOK-FOK)	ROAD RES. WIDTH	PATH WIDTH
SCARLETT STREET	2.25 E	2.75 E	2.60 W	120 W	NA	4.35 E 4.05 W	7.30	16.00	150 BOTH
ROSETTE CRESCENT	2.25 W	2.75 W	2.60 E	120 E	NA	4.05 E 4.35 W	7.30	16.00	150 BOTH
CARNATION DRIVE	2.25 E	2.75 E	2.60 W	1.85 W	NA	9.65 E 4.35 W	7.00 TRAFFIC LANES 2x2.10 PARKING BAYS	25.50	150 BOTH 3.00 BIKE (E)
BRIDGEFIELD PARKWAY (lots 409-427)	2.25 S	2.75 S	4.55 N	3.725 N	NA	5.90 N 4.40 S	7.30 TRAFFIC LANES 1x2.10 PARKING BAY	20.00	3.00 SHARED (N) 1.50 (S)
BRIDGEFIELD PARKWAY (adjacent to park reserve)	2.25 S	2.75 S	4.10 N	3.275 N	NA	5.90 N 4.40 S	7.30 TRAFFIC LANES 1x2.10 PARKING BAY	20.00	3.00 SHARED (N) 1.50 (S)
ALTHEA WAY	2.25 N	2.75 N	2.60 S	1.80 S	100 N	4.35 N 4.05 S	7.30	16.00	150 BOTH
LAUREL STREET (lots 453-462)	2.25 S	2.75 S	2.45 N	1.85 N	100 N	4.05 N 4.35 S	7.30	16.00	150 BOTH
LAUREL STREET (lots 463-464)	2.25 S	2.75 S	2.40 N	1.85 N	100 N	4.05 N 4.35 S	7.30	16.00	150 BOTH
GREENVIEW AVENUE	2.25 N	2.75 N	2.60 S	1.85 S	NA	9.65 N 4.35 W	7.00 TRAFFIC LANES 2x2.10 PARKING BAYS	25.50	150 BOTH 3.00 BIKE (N)
PRIMROSE AVENUE	2.25 E	2.75 E	2.45 W	1.80 W	NA	4.35 E 4.05 W	7.30	16.00	150 BOTH
FLORAL WAY	2.25 W	2.75 W	2.60 E	1.85 E	NA	4.05 E 4.35 W	7.30	16.00	150 BOTH
CALEDONIA AVENUE	2.25 W	2.75 W	2.60 E	1.85 E	NA	4.05 E 4.35 W	7.30	16.00	150 BOTH
LANEWAY Y	NA	NA	NA	NA	150 W	0.50 E 0.50 W	6.00	7.00	NA
LANEWAY Z	NA	NA	NA	NA	150 W	0.50 E 0.50 W	6.00	7.00	NA


LEGEND

- B2 600 B2 TYPE KERB AS PER EDM 301
- ES 150x150mm CONC. EDGE STRIP WITH SUBSOIL DRAINS UNDER.
- TEMPORARY TURNING AREA INCLUDING BOLLARDS AND "NO ROAD" SIGN.
- PROPOSED RAISED PAVEMENT.
- PROPOSED GAS & WATER/RECYCLED WATER CONDUITS
- PROPOSED ELECT. & TELECOMM. CONDUITS
- EXISTING SURFACE CONTOURS (0.25m INT.)
- DIRECTION OF LOT FINISHED SURFACE FALL / OVERLAND FLOW PATH
- 3.0m BIKE PATH 3.0m BIKE PATH. REFER TO EDM 401 FOR DETAILS.
- ULTIMATE WATERWAY CHANNEL. (SHAPING ARE SHOWN AS INDICATIVE ONLY)
- PROPOSED BOLLARDS AS PER LANDSCAPE PLAN


LEGEND

- CUT EARTHWORKS - CUT AREA WITHIN LOTS GREATER THAN 150mm DEPTH
- FILL EARTHWORKS - FILL AREA WITHIN LOTS GREATER THAN 150mm DEPTH

THIS PLAN SHOWS ONLY APPROXIMATE EXTENTS & LEVELS OF FILL TO BE PLACED DURING CONSTRUCTION. DEPTH OF FILL USED FOR TOP DRESSING ALL ALLOTMENTS MAY VARY BY UP TO 0.15m. THE EXTENT OF FILL SHOWN IS BASED ON DESIGN AND MAY BE SUBJECT TO CHANGE FOLLOWING FINAL INSPECTION BY GEOTECHNICAL ENGINEER.

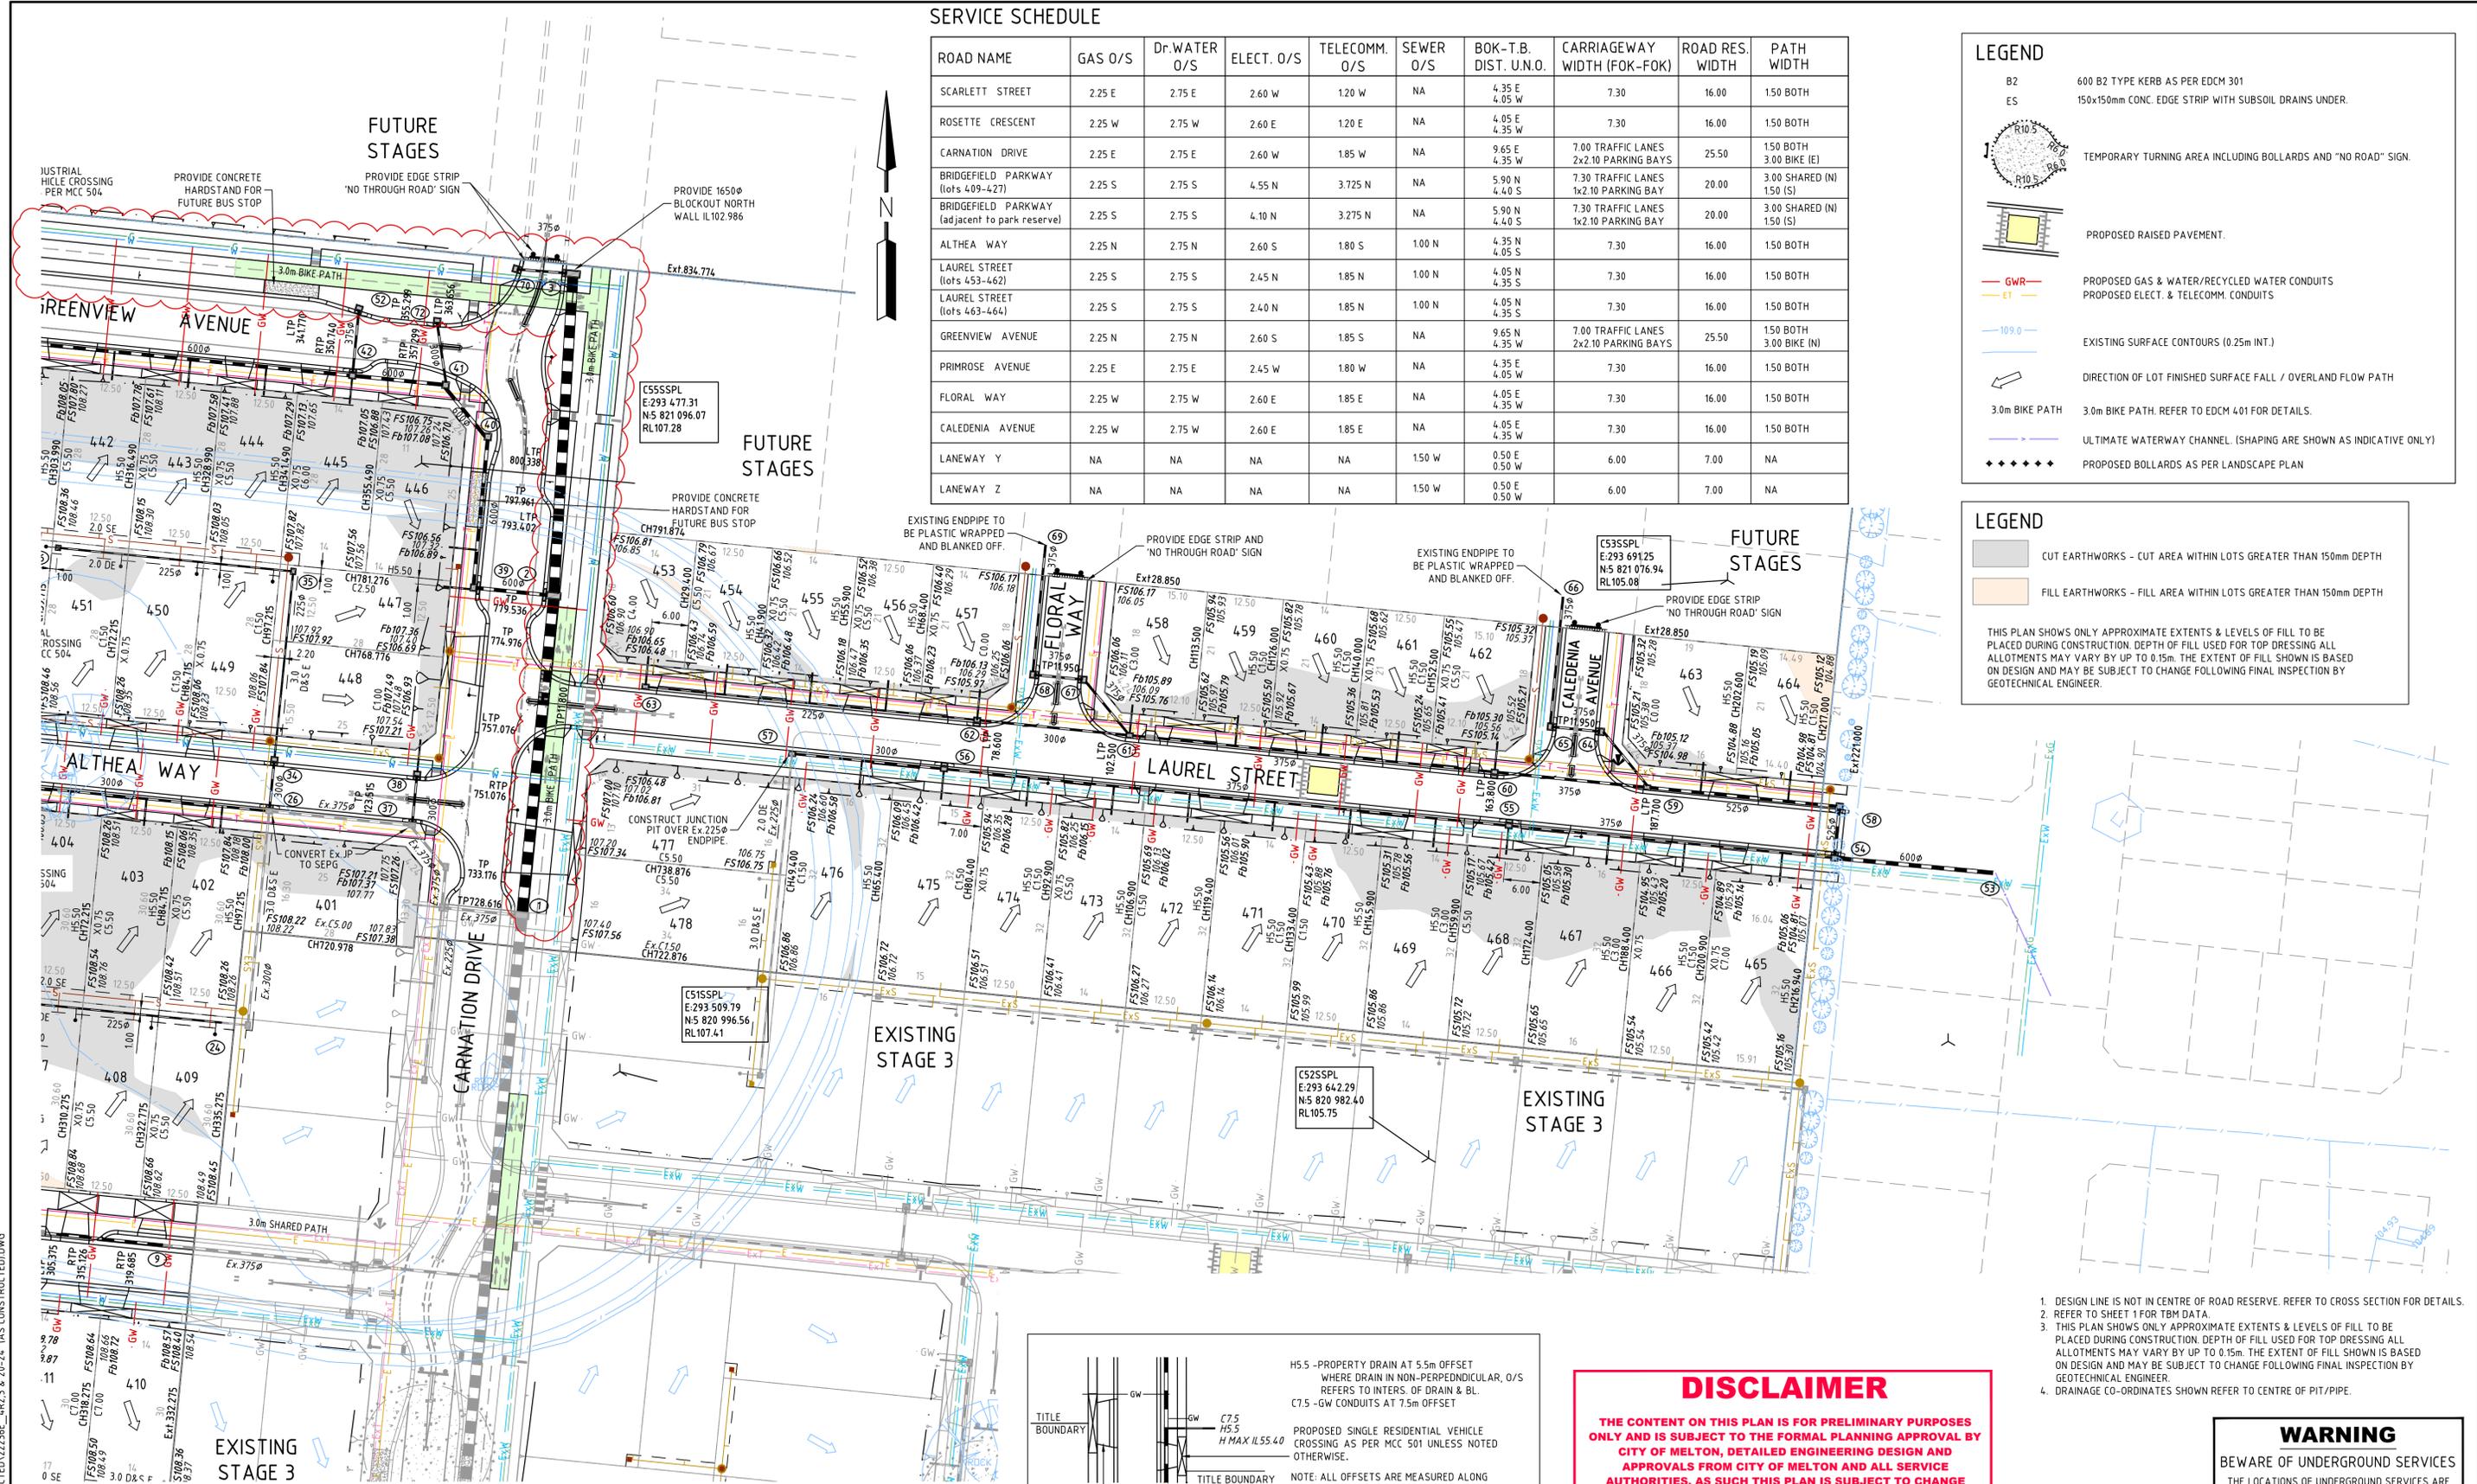

LAYOUT PLAN
Scale 1:500 @ A1

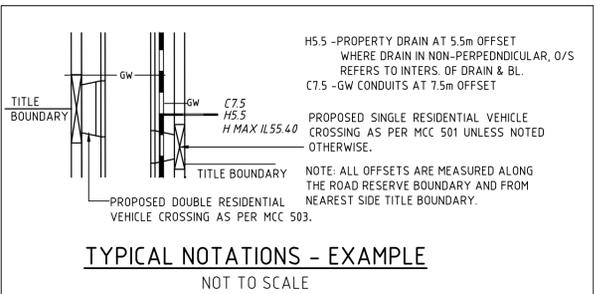

DISCLAIMER

THE CONTENT ON THIS PLAN IS FOR PRELIMINARY PURPOSES ONLY AND IS SUBJECT TO THE FORMAL PLANNING APPROVAL BY CITY OF MELTON, DETAILED ENGINEERING DESIGN AND APPROVALS FROM CITY OF MELTON AND ALL SERVICE AUTHORITIES. AS SUCH THIS PLAN IS SUBJECT TO CHANGE WITHOUT NOTICE. THIS PLAN IS NOT TO BE USED FOR ANY PURPOSE OTHER THAN FOR PRELIMINARY PURPOSES. HOUSE SITING SHOULD ONLY BE COMPLETED ONCE COUNCIL APPROVED PLANS ARE ISSUED. THE DEVELOPER BEARS NO RESPONSIBILITY FOR ANY OF THESE CHANGES. THE PURCHASER SHOULD ASCERTAIN THE DETAILS ARE CORRECT BEFORE PROCEEDING.

- DESIGN LINE IS NOT IN CENTRE OF ROAD RESERVE. REFER TO CROSS SECTION FOR DETAILS.
- REFER TO SHEET 1 FOR TBM DATA.
- THIS PLAN SHOWS ONLY APPROXIMATE EXTENTS & LEVELS OF FILL TO BE PLACED DURING CONSTRUCTION. DEPTH OF FILL USED FOR TOP DRESSING ALL ALLOTMENTS MAY VARY BY UP TO 0.15m. THE EXTENT OF FILL SHOWN IS BASED ON DESIGN AND MAY BE SUBJECT TO CHANGE FOLLOWING FINAL INSPECTION BY GEOTECHNICAL ENGINEER.
- DRAINAGE CO-ORDINATES SHOWN REFER TO CENTRE OF PIT/PIPE.

WARNING

BEWARE OF UNDERGROUND SERVICES

THE LOCATIONS OF UNDERGROUND SERVICES ARE APPROXIMATE ONLY AND THEIR EXACT POSITION SHOULD BE PROVEN ON SITE. NO GUARANTEE IS GIVEN THAT ALL EXISTING SERVICES ARE SHOWN.

AS CONSTRUCTED

THIS DRAWING IS NOT TO BE COPIED OR SCALED

J	AS CONSTRUCTED	25.06.19	DJK
I	PAINTED BIKE PATH AT INTERSECTION	26.03.19	LP
H	NBN OFFSET	09.04.18	LP
G	CONSTRUCTION ISSUE	08.03.18	LP
F	DIRECTIONAL TACTILE PAVER UPDATED	05.03.18	LP
VERSION	REMARKS		

LEGEND	
	DRAIN, PROPERTY INLET & PIT
	SEWER AND MAINTENANCE HOLE
	WATER MAIN
	GAS MAIN
	ELECTRICAL SERVICE & PIT
	ELECTRICAL ASSETS
	GAS & WATER CONDUITS
	TOP OF BATTER
	RECYCLED WATER
	ELECTRICAL U.G. SERVICES
	SEWER AND MAINTENANCE HOLE
	WATER MAIN